


PRELIMINARY ONLY

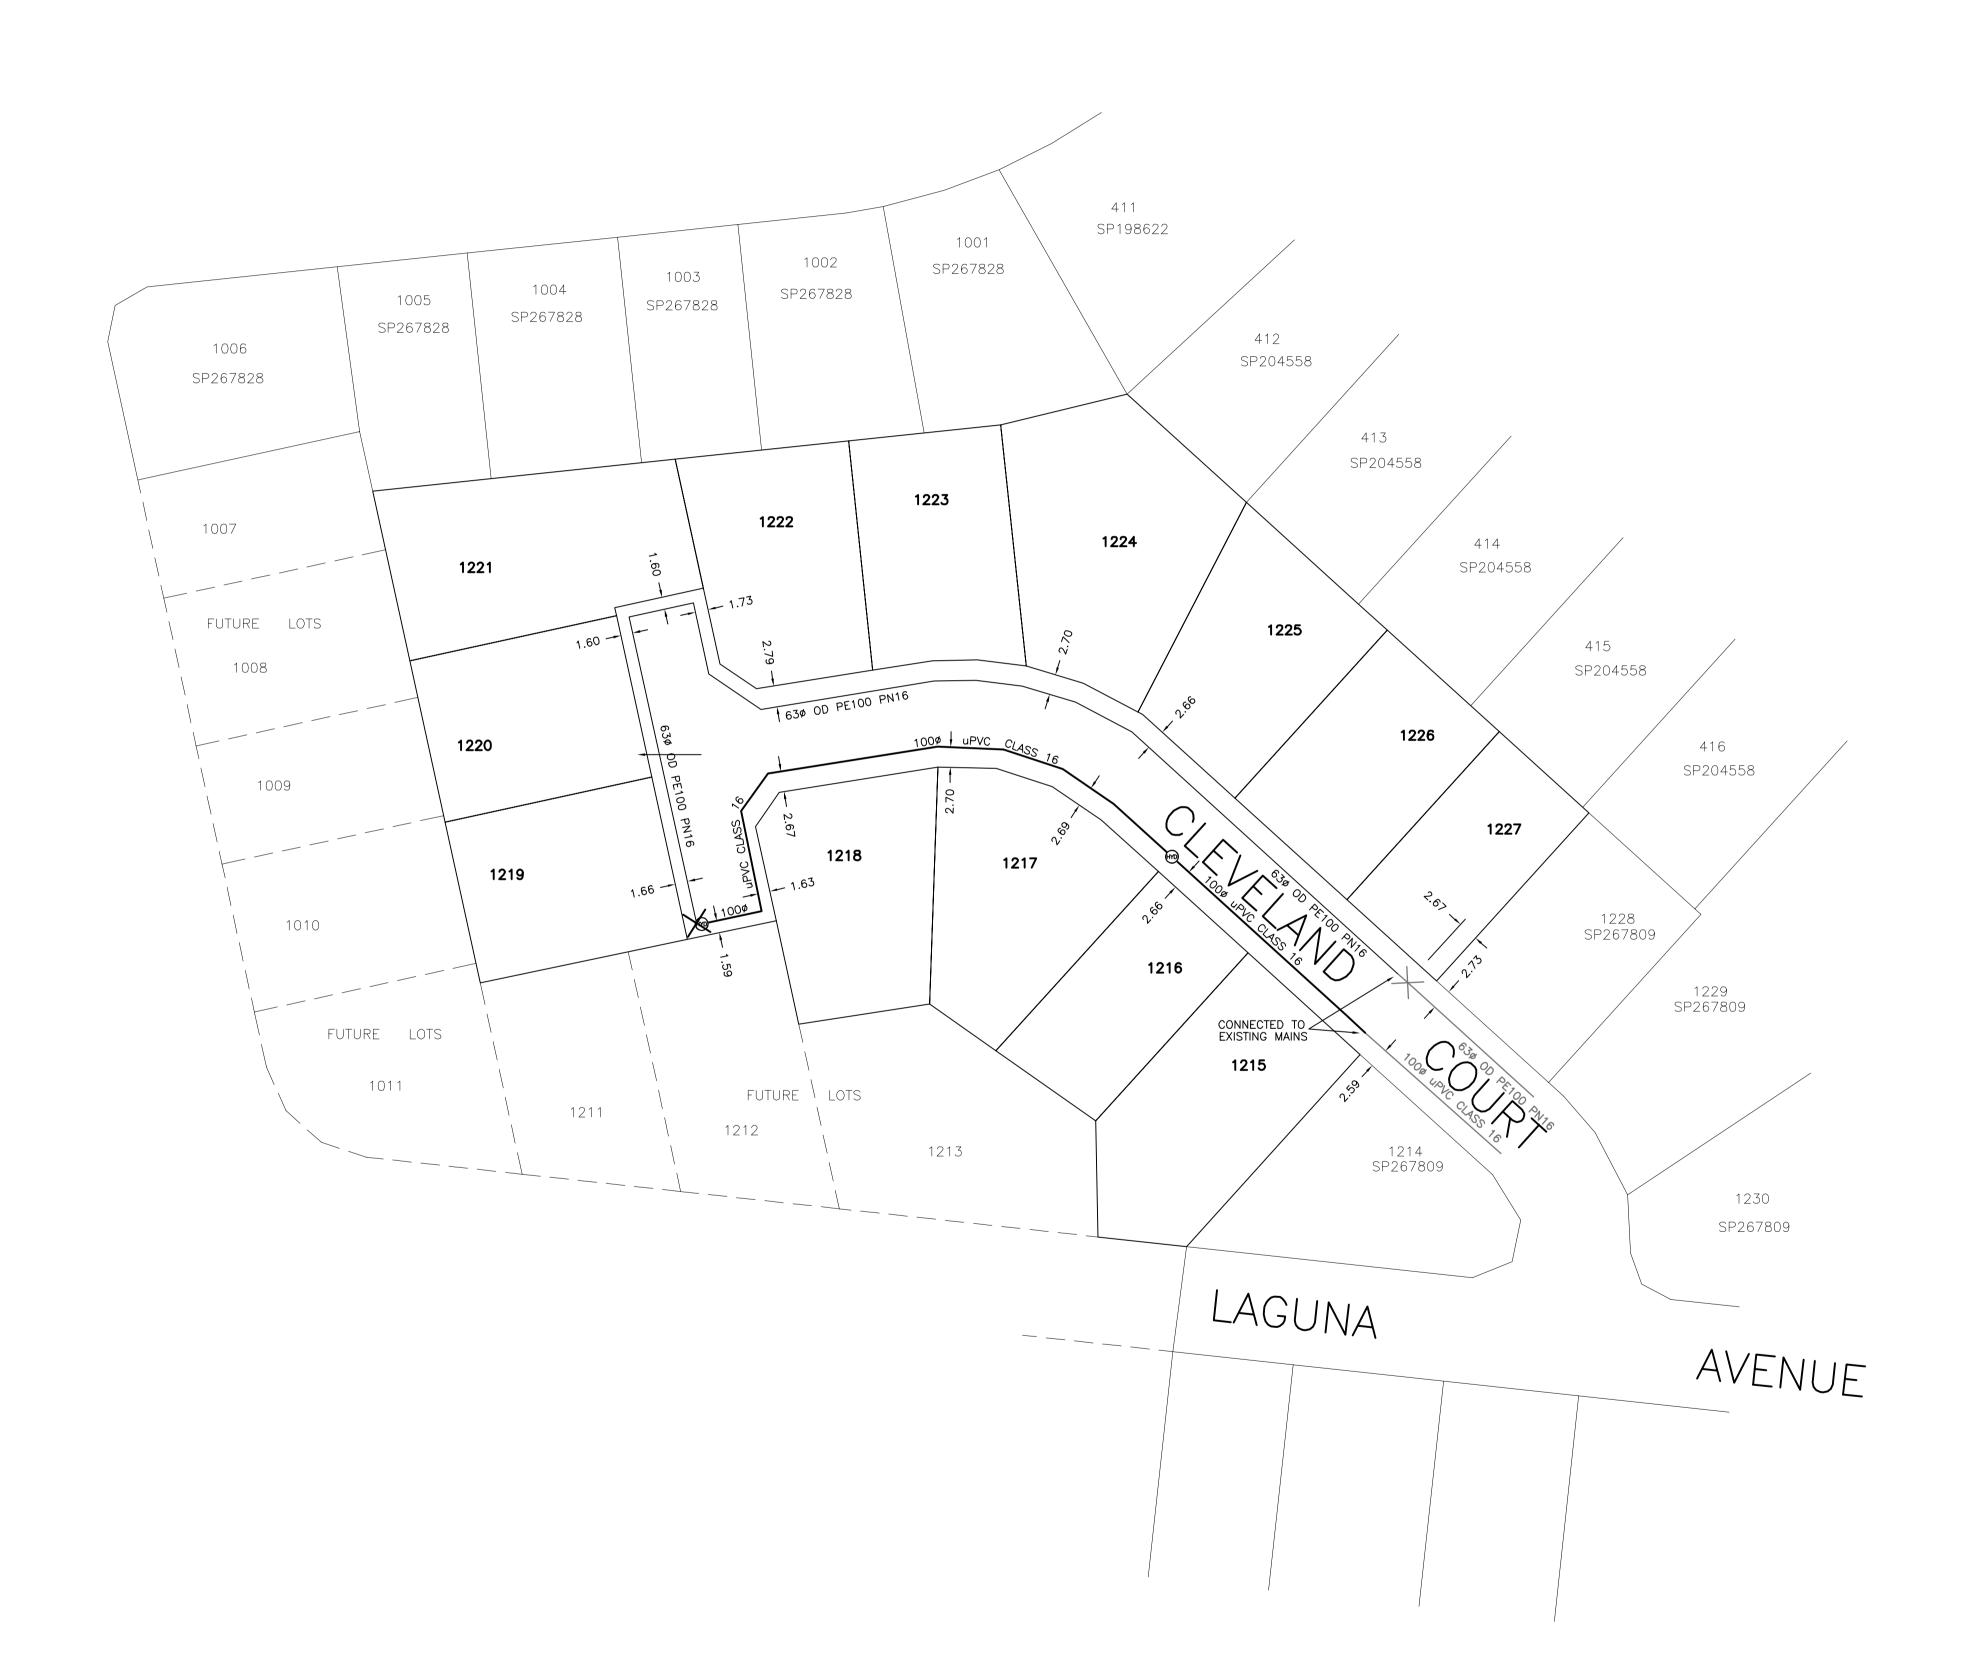

LEGEND

⊕ HYDRANT X STOP VALVE

☐ END CAP

PRELIMINARY ONLY

CERTIFICATION

RPS Australia East Pty Ltd (ACN 140 292 762), certifies that the locations of the water infrastructure on this plan have been surveyed in accordance with the requirements of the FNQROC Development Manual and, to the best of our knowledge and subject to the Important Note below, are accurate.

...Authorised Delegate

This plan was prepared for the sole purposes of the client for the specific purpose of recording the infrastructure for the Cairns Regional Council. This plan is strictly limited to the Purpose and does not apply directly or indirectly and will not be used for any other application, purpose, use or matter. The plan is presented without the assumption of a duty of care to any other person (other than the Client) ("Third Party") and may not be relied on by Third Party.

2. RPS Australia East Pty Ltd will not be liable (in negligence or otherwise) for any direct or indirect loss, damage, liability or claim arising out of or incidental to:

A. Third Party publishing, using or relying on the plan; B. RPS Australia East Pty Ltd relying on information provided to it by the Client or a Third Party where the information is incorrect, incomplete,

inaccurate, out-of-date or unreasonable; C. any inaccuracies or other faults with information or data sourced from

D. RPS Australia East Pty Ltd relying on surface indicators that are incorrect or inaccurate;

E. the Client or any Third Party not verifying information in this plan where recommended by RPS Australia East Pty Ltd;

F. lodgement of this plan with any local authority against the recommendation of RPS Australia East Pty Ltd; G. the accuracy, reliability, suitability or completeness of any

approximations or estimates made or referred to by RPS Australia East Pty Ltd in this plan. Without limiting paragraph 1 or 2 above, this plan may not be copied,

distributed, or reproduced by any process unless this note is clearly displayed on the plan.

4. Scale shown is correct for the original plan and any copies of this plan should be verified by checking against the bar scale.

5. Stop valves, hydrants and other visible surface indicators have been located by survey. Other information has been obtained from design and construction information [provided by Third Parties] and should be checked

6. The positions of some services shown on this plan have been exaggerated for drawing clarity purposes. Dimensions shown take precedence over

NOTES


Level Datum: AHD-D

Origin of Levels: PSM 99381 RL 30.339

Meridian: MGA Zone 55 - GDA94

Origin of Coordinates: PSM 186208

N 8131383.697

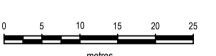

SCALE 1:500 IS APPLICABLE ONLY TO THE ORIGINAL SHEET SIZE. (A1) (1:1000 @ A3)

PROJECT MANAGER			SURVEYED	
D. GARGET			PB	12/9/2019
COMPILED			CAD REF	
AMK			5159-251.DWG	
SHEET SIZE	SHEET	1	Stage 12 B_asc	

ACN 140 292 762 135 Abbott St PO Box 1949
CAIRNS QLD 4870
T +61 7 4031 1336



© COPYRIGHT PROTECTS THIS PLAN

FGF DEVELOPMENTS

SPRINGBROOK STAGE 12B **AS-CONSTRUCTED** WATER RETICULATION

23/9/2019 5159-251