

REGISTERED SURVEYOR'S CERTIFICATION


We, **VERIS AUSTRALIA PTY LTD**, hereby certify that the vertical and horizontal locations and dimensions shown on this plan are a true and correct record and were located by survey.

Delegate Cadastral Surveyor (Sig) Reg. Surveyor No. **6448** Date **4/10/2023**

ENGINEER'S CERTIFICATION


I, **Brent Milton** being a Certified/Registered Engineer and
(Engineer's Name)
duly authorised representative of **COVEY ASSOCIATES PTY LTD**
(Consulting firm or company)

- Hereby:-
- certify the information contained in this drawing/file is an accurate "as constructed" representation of the works;
 - accept responsibility for the "as constructed" information contained in this drawing/file, and
 - acknowledge the "as constructed" information contained in this drawing/file map be relied on by the Council and others


Certification for Stage **28** by  on **09/10/2023**
(Stage No) (Signature) (Date)

for **COVEY ASSOCIATES PTY LTD**
(Company Name)
Registered Professional Engineering Company of Queensland **27473**
(Number)


Note:
(1) The Hatched Suffix indicates the use of a Design Feature.
eg. 7/1H
eg. SL 20.519H **
(4) The Star Suffix indicates Future Feature.

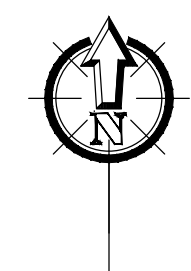

SHEET 2

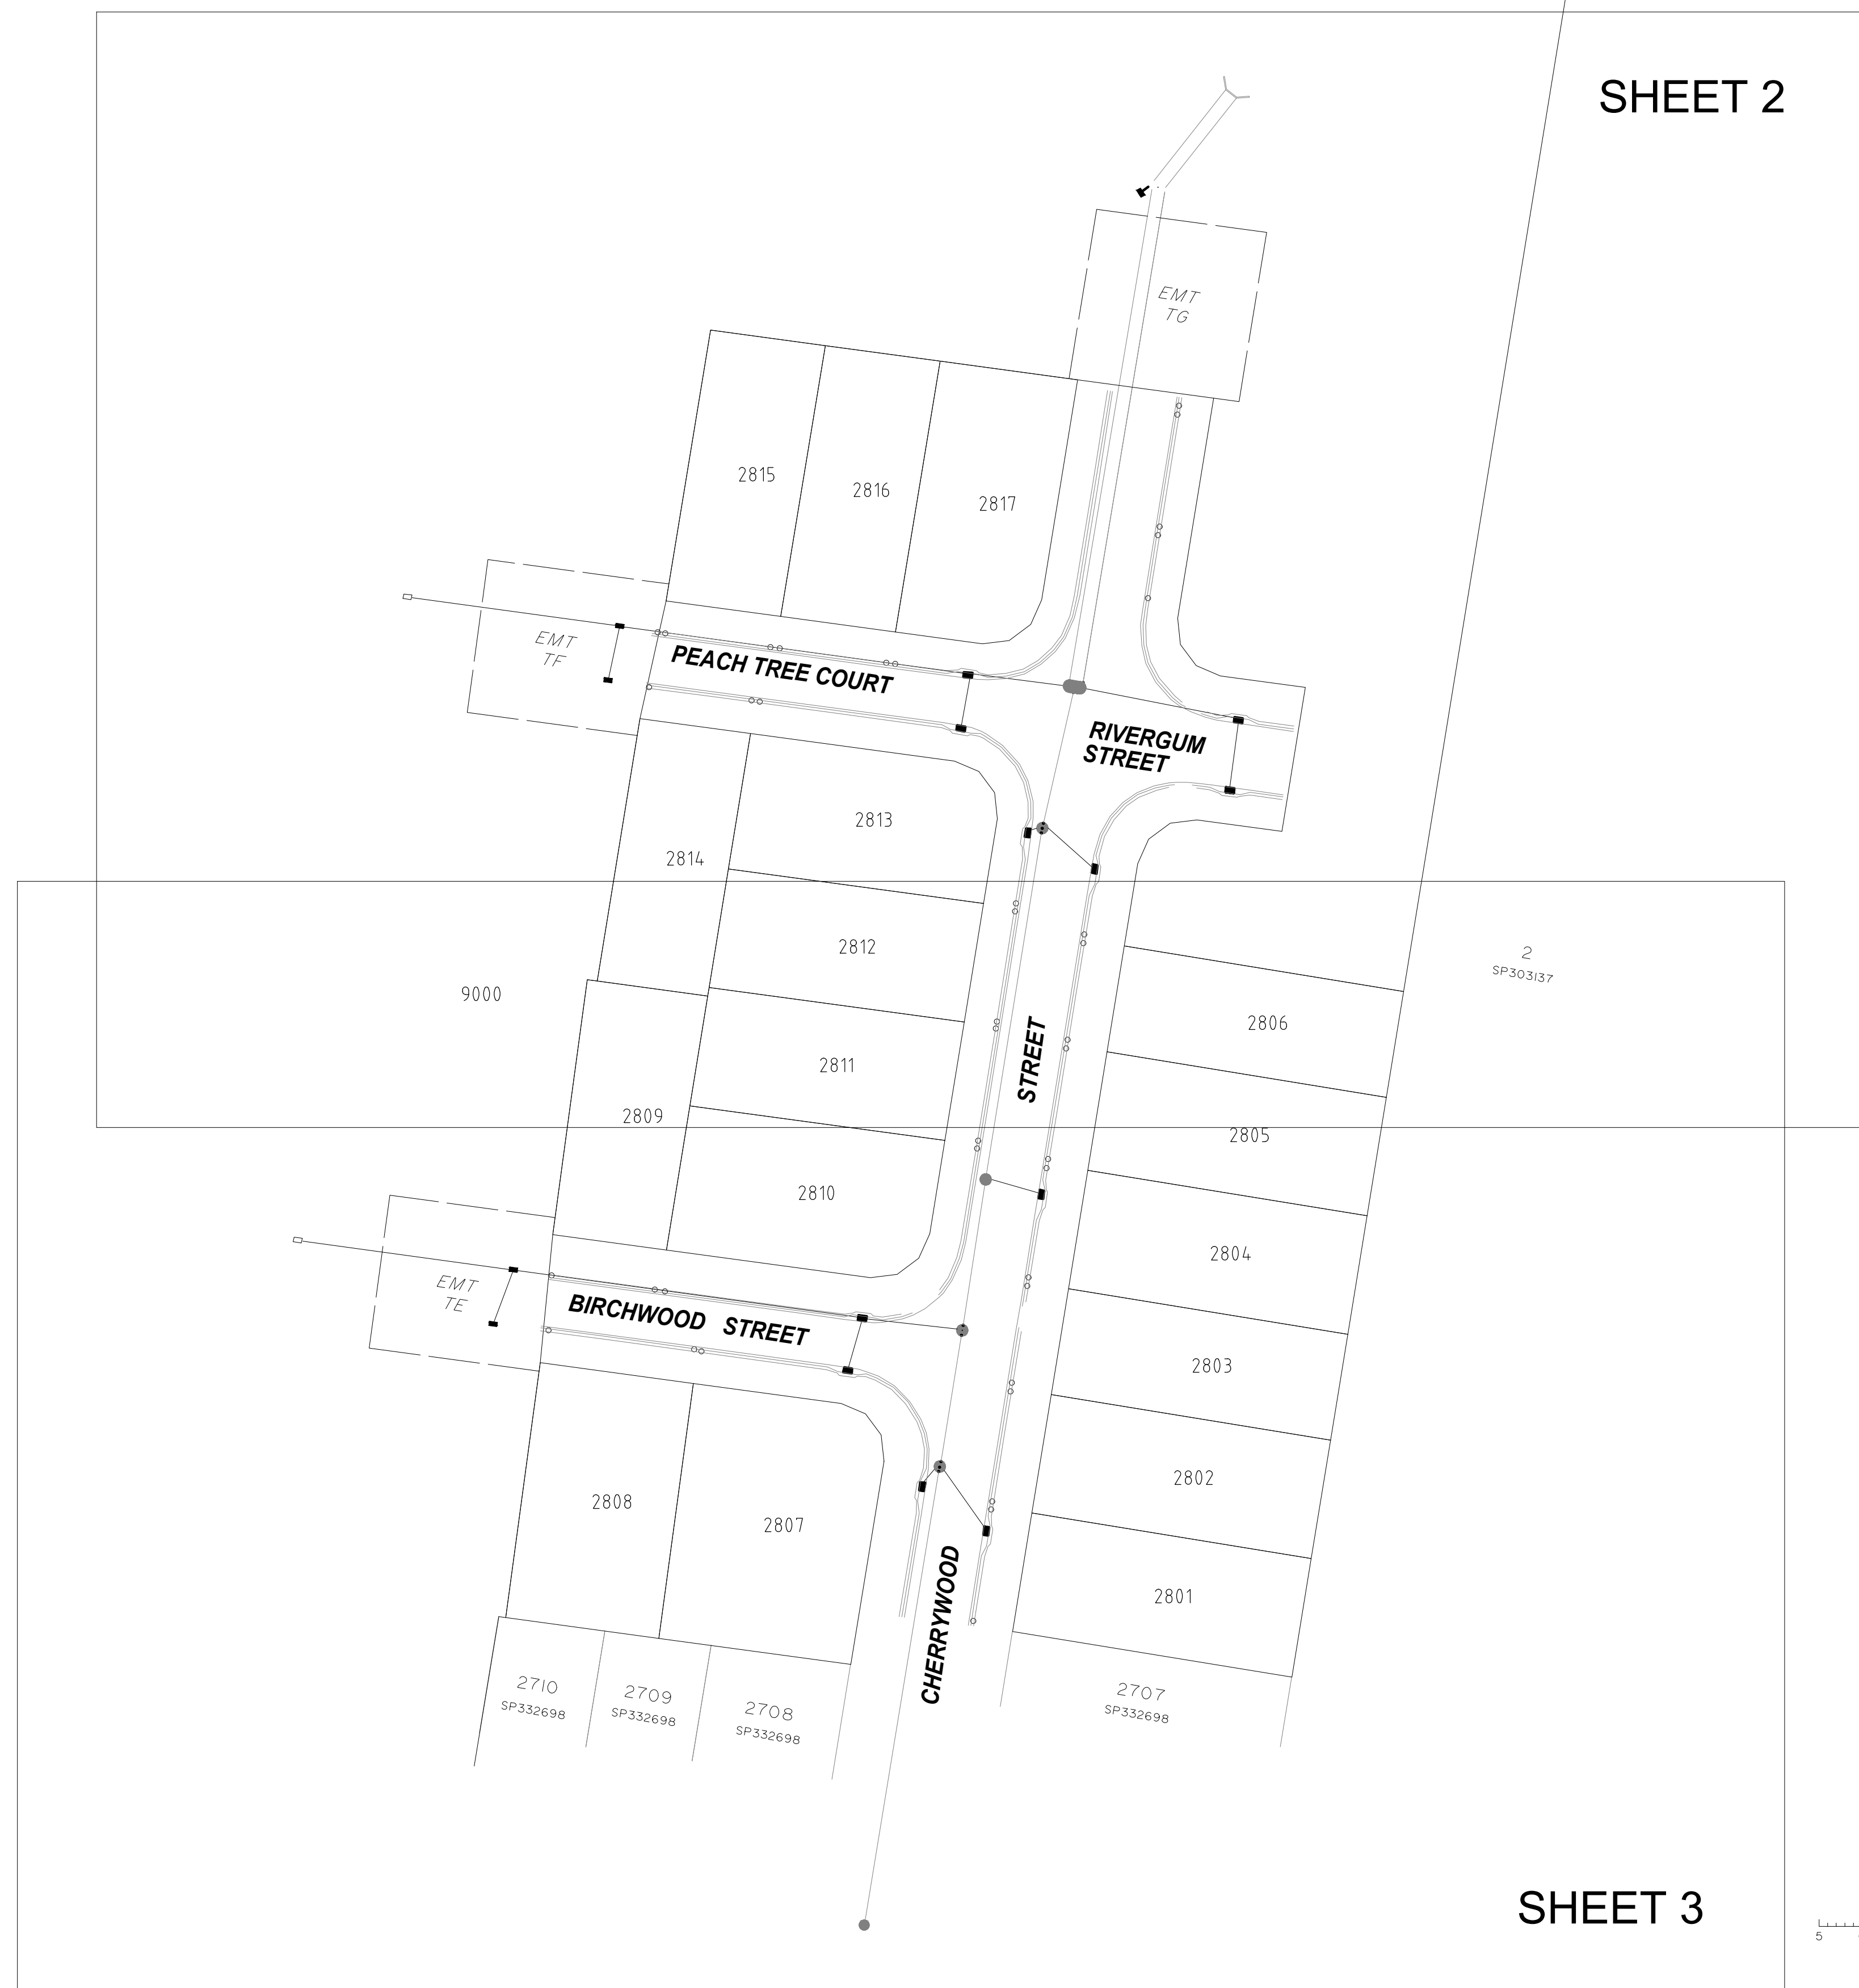

SHEET 3

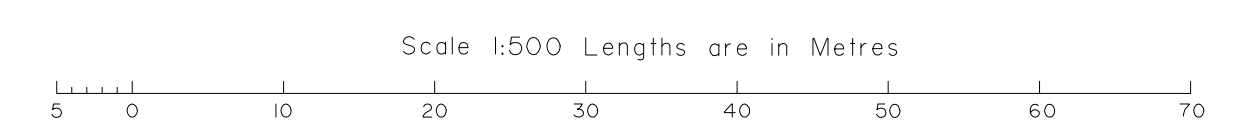

COORDINATE DATUM NOTE:
HORIZONTAL COORDINATES(E,N) SUPPLIED ARE MAPPING GRID OF AUSTRALIA(MGA), ZONE 56 BASED ON THE UNIVERSAL TRANSVERSE MERCATOR PROJECTION AND THE GEOCENTRIC DATUM OF AUSTRALIA 2020.
HORIZONTAL DATUM DERIVED FROM PM33280, E 4 92232.695, N 7002358.634.
LEVELS SUPPLIED ARE ON THE AUSTRALIAN HEIGHT DATUM(AHD)
LEVEL DATUM DERIVED FROM PSM108673 RL 17.338 (AHD)

DRAWING REVISIONS		REFERENCE DRAWINGS		DESIGN FILE No.	DESIGNED
REV.	REVISION DESCRIPTION	DRG. No.	DESCRIPTION	CONSTRUCT. No.	DATE
A	Original 25/07/2023				
B	Add G1/19, Chg Pipe Mat 20/09/2023				
				FIELD BOOK	DATE 25/07/2023
				LOG BOOK	CHECKED MJT
				LEVEL DATUM	DATE 20/09/2023
				DATUM	PM 108673 RL 17.338

veris
BRISBANE (07) 3666 4700 WHITSUNDAYS (07) 4945 6600
MACKAY (07) 4957 9700 CAIRNS (07) 4252 9400
veris.com.au
ACN 615 735 727
Veris Australia Pty Ltd

Moreton Bay
Regional Council

SCALE 1:500 ORIGINAL SIZE A1

MORETON BAY REGIONAL COUNCIL
CABOOLTURE DISTRICT OFFICE
2 HASKING STREET CABOOLTURE QLD 4510
PO BOX 159 CABOOLTURE QLD 4510
Telephone: (07) 5433 0100
Fax: (07) 5433 4000

**STAGES 28
RIVERPARKS ESTATE
AS CONSTRUCTED
STORMWATER DRAINAGE**

MBRC SUBDIVISION REFERENCE	
DA/28428/2013/VCHG/1	
No. 1 OF 3 PLANS	REV.
431132-28-ASW	B

REGISTERED SURVEYOR'S CERTIFICATION

We, **VERIS AUSTRALIA PTY LTD**, hereby certify that the vertical and horizontal locations and dimensions shown on this plan are a true and correct record and were located by survey.

Delegate Cadastral Surveyor (sig) Reg. Surveyor No. **6448** Date: **4/10/2023**

ENGINEER'S CERTIFICATION

I, **Brent Milton**, being a Certified/Registered Engineer and *(Engineer's Name)* duly authorised representative of **COVEY ASSOCIATES PTY LTD** *(Consulting firm or company)*

Hereby:-

- certify the information contained in this drawing/file is an accurate "as constructed" representation of the works;
- accept responsibility for the "as constructed" information contained in this drawing/file; and
- acknowledge the "as constructed" information contained in this drawing/file map be relied on by the Council and others.


Certification for Stage **28** by *(Signature)* on **09/10/2023** *(Date)*

for **COVEY ASSOCIATES PTY LTD** *(Company Name)*

Registered Professional Engineering Company of Queensland **27473** *(Number)*

Note:
 (1) The Hatched Suffix indicates the use of a Design Feature.
 eg. 7/1m
 eg. SL 20.519# **
 (4) The Star Suffix indicates Future Feature.

COORDINATE DATUM NOTE:
 HORIZONTAL COORDINATES(E,N) SUPPLIED ARE MAPPING GRID OF AUSTRALIA(IMG), ZONE 56 BASED ON THE UNIVERSAL TRANSVERSE MERCATOR PROJECTION AND THE GEOCENTRIC DATUM OF AUSTRALIA 2020.
 HORIZONTAL DATUM DERIVED FROM PM33280, E 492232.695, N 7002358.634.
 LEVELS SUPPLIED ARE ON THE AUSTRALIAN HEIGHT DATUM(AHD)
 LEVEL DATUM DERIVED FROM PSM108673 RL 17.338 (AHD)

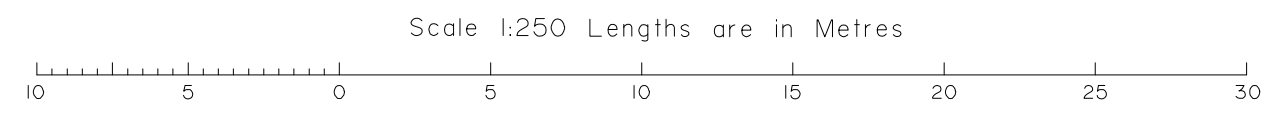

DRAWING REVISIONS		REFERENCE DRAWINGS		DESIGN FILE No.	DESIGNED
REV.	REVISION DESCRIPTION	DRG. No.	DESCRIPTION	CONSTRUCT. No.	DATE
A	Original	25/07/2023		SURVEY FILE No. 431132-28-ASW A	DRAWN PL
B	Add G1/19, Chg Pipe Mat	20/09/2023		FIELD BOOK	DATE 25/07/2023
				LOG BOOK	CHECKED MJT
				LEVEL DATUM	DATE 20/09/2023
				DATUM	PM 108673 RL 17.338


veris
 BRISBANE (07) 3666 4700 WHITSUNDAYS (07) 4945 6600
 MACKAY (07) 4967 9700 CAIRNS (07) 4252 3400
 veris.com.au
 ACN 615 735 727
 Veris Australia Pty Ltd

SCALE 1:250 ORIGINAL SIZE A1

Moreton Bay Regional Council
 MORETON BAY REGIONAL COUNCIL
 CABOOLTURE DISTRICT OFFICE
 2 HASKING STREET CABOOLTURE QLD 4510
 PO BOX 159 CABOOLTURE QLD 4510
 Telephone: (07) 5433 0100
 Fax: (07) 5433 4000

**STAGES 28
 RIVERPARKS ESTATE
 AS CONSTRUCTED
 STORMWATER DRAINAGE**

MBRC SUBDIVISION REFERENCE	
DA/28428/2013/VCHG/1	
No. 2 OF 3 PLANS	
DRAWING NUMBER	REV.
4 31132-28-ASW	B

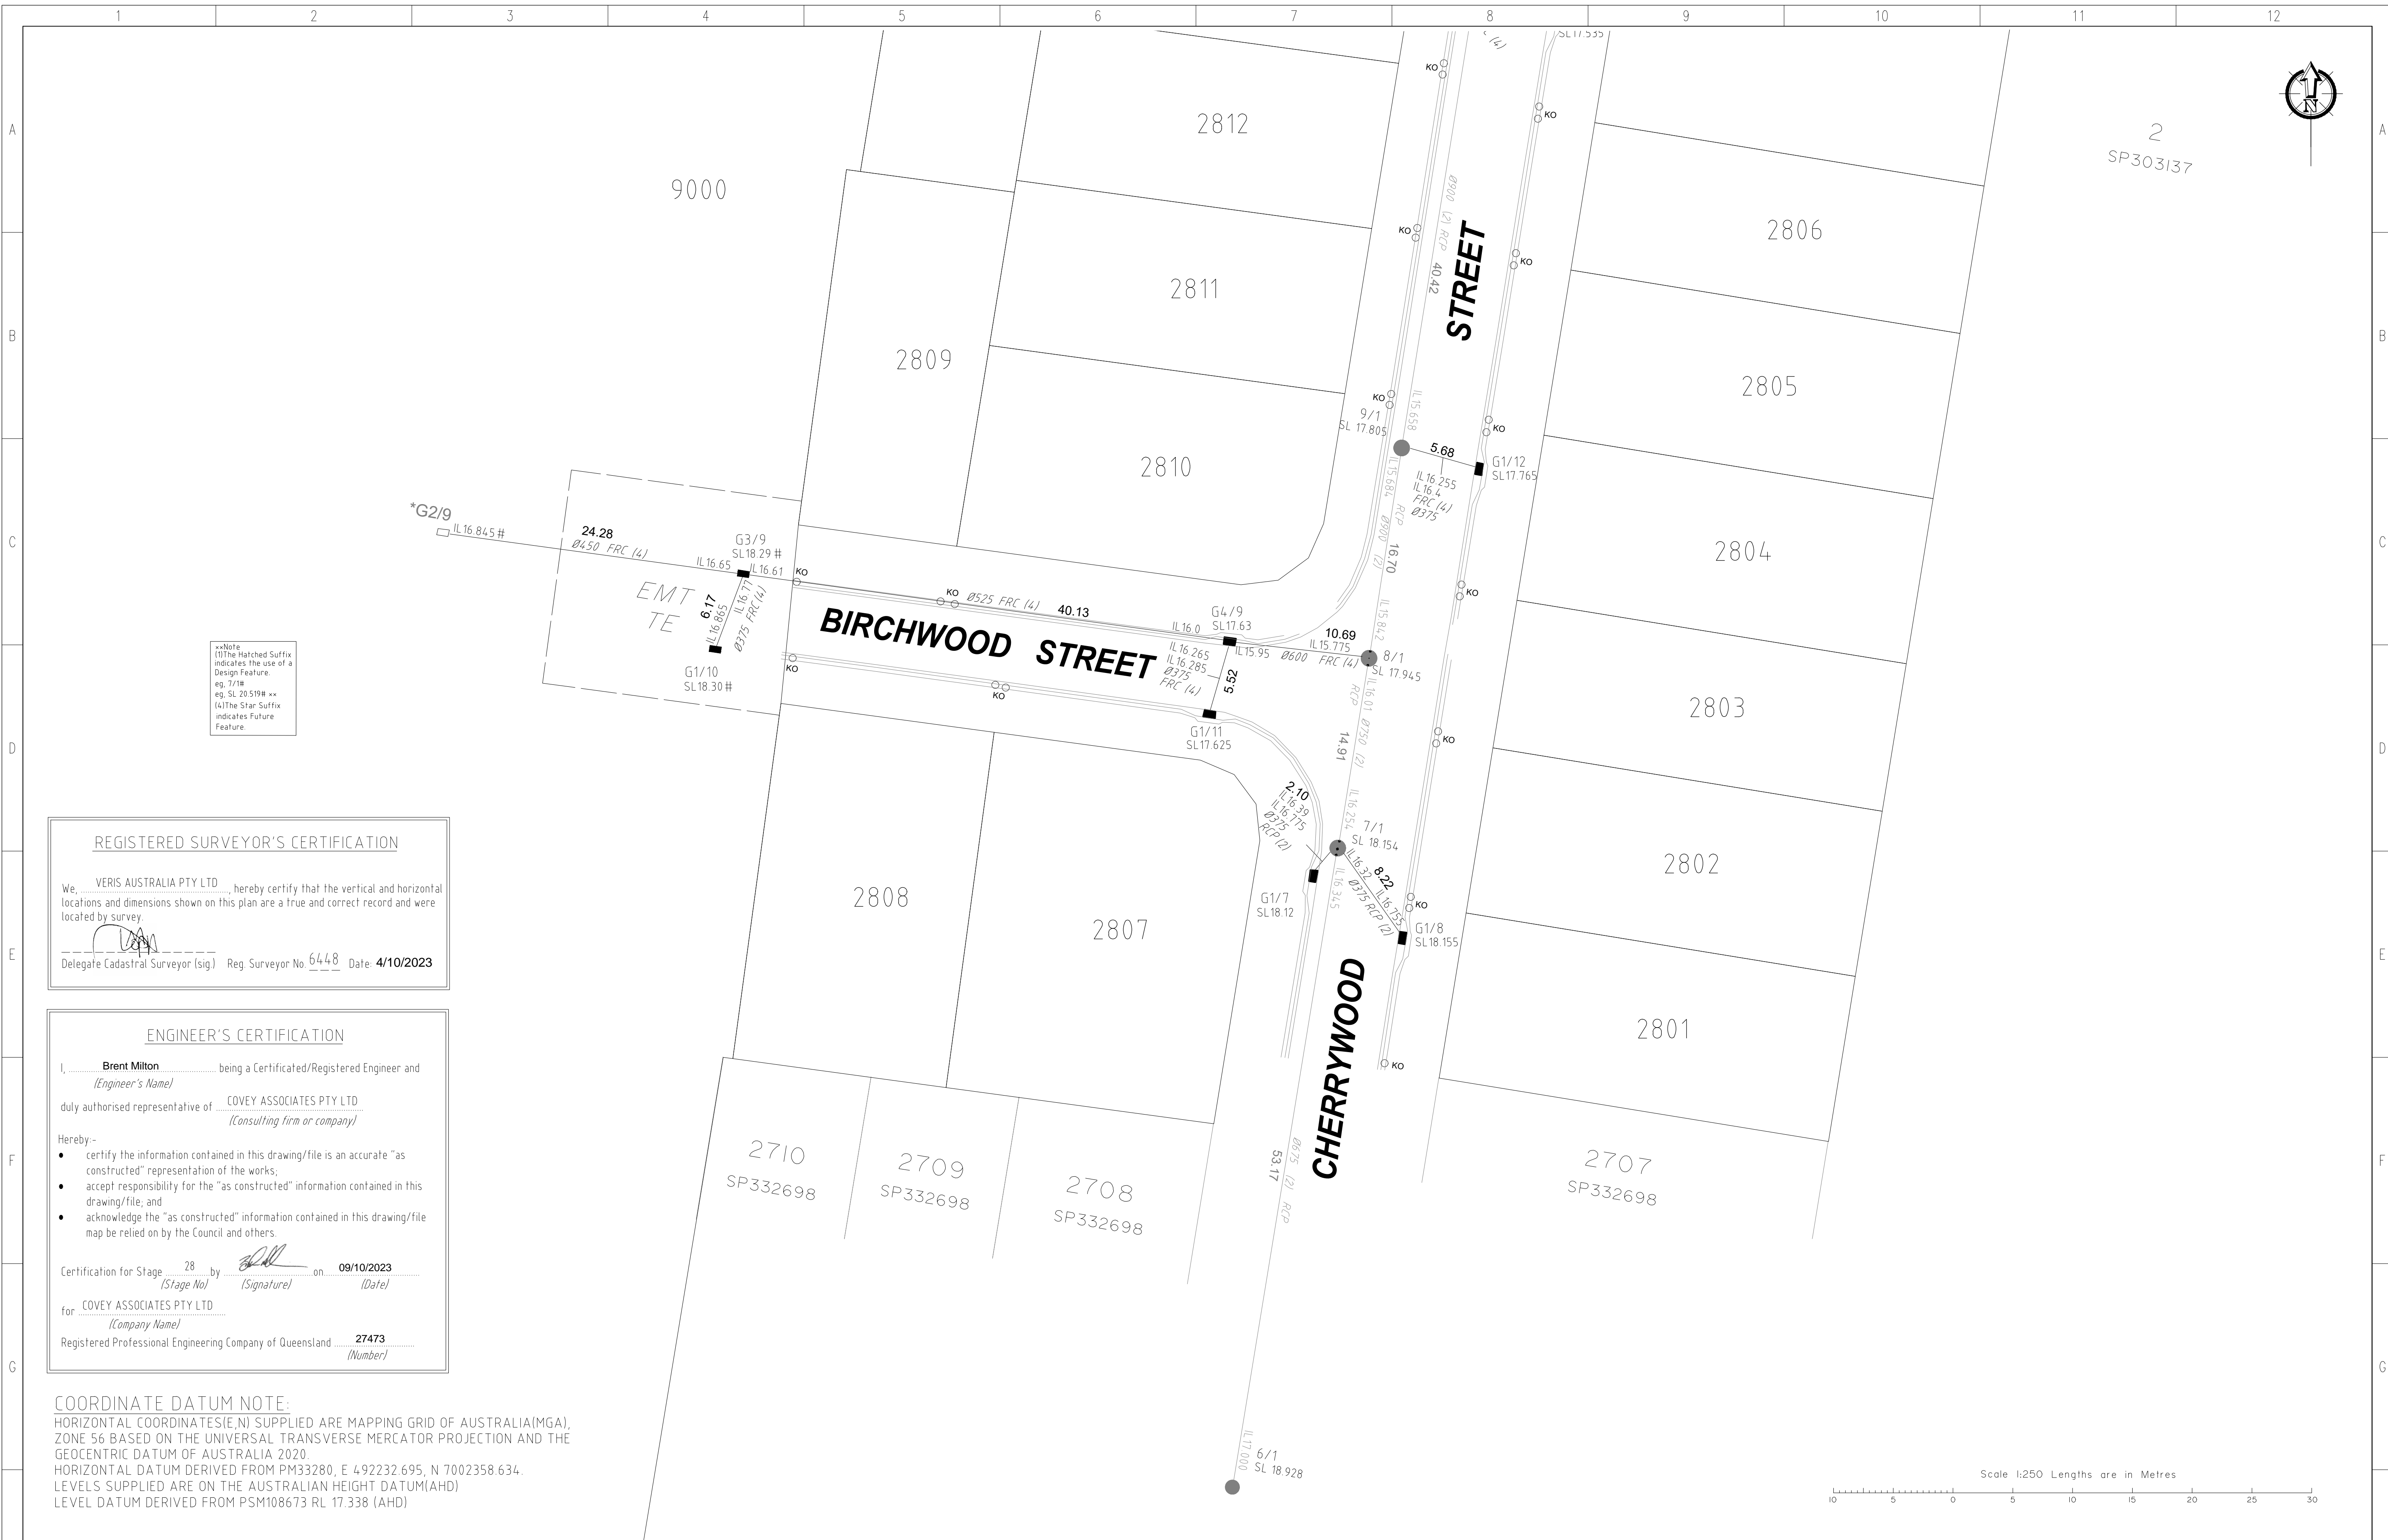

*Hatched
 (1) The Hatched Suffix
 indicates the use of a
 Design Feature.
 eg. 7/1#
 eg. SL 20.519# *
 (4) The Star Suffix
 indicates Future
 Feature.

REGISTERED SURVEYOR'S CERTIFICATION

We, **VERIS AUSTRALIA PTY LTD**, hereby certify that the vertical and horizontal locations and dimensions shown on this plan are a true and correct record and were located by survey.



 Delegate Cadastral Surveyor (sig) Reg. Surveyor No. **6448** Date **4/10/2023**

ENGINEER'S CERTIFICATION

I, **Brent Milton**, being a Certified/Registered Engineer and
(Engineer's Name)
 duly authorised representative of **COVEY ASSOCIATES PTY LTD**
(Consulting firm or company)


Hereby:-

- certify the information contained in this drawing/file is an accurate "as constructed" representation of the works;
- accept responsibility for the "as constructed" information contained in this drawing/file; and
- acknowledge the "as constructed" information contained in this drawing/file may be relied on by the Council and others.


Certification for Stage **28** by  on **09/10/2023**
(Stage No) *(Signature)* *(Date)*

for **COVEY ASSOCIATES PTY LTD**
(Company Name)
 Registered Professional Engineering Company of Queensland **27473**
(Number)


COORDINATE DATUM NOTE:
 HORIZONTAL COORDINATES(E,N) SUPPLIED ARE MAPPING GRID OF AUSTRALIA(MGA), ZONE 56 BASED ON THE UNIVERSAL TRANSVERSE MERCATOR PROJECTION AND THE GEOCENTRIC DATUM OF AUSTRALIA 2020.
 HORIZONTAL DATUM DERIVED FROM PM33280, E 492232.695, N 7002358.634.
 LEVELS SUPPLIED ARE ON THE AUSTRALIAN HEIGHT DATUM(AHD)
 LEVEL DATUM DERIVED FROM PSM108673 RL 17.338 (AHD)

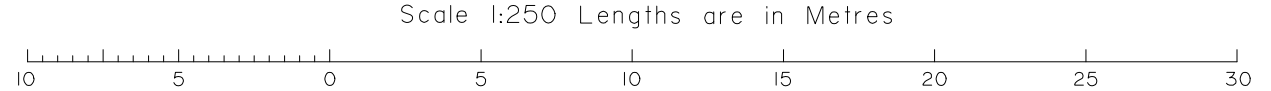

DRAWING REVISIONS		REFERENCE DRAWINGS		DESIGN FILE No.		DESIGNED	
REV.	REVISION DESCRIPTION	DRG. No.	DESCRIPTION	CONSTRUCT. No.		DATE	
A	Original	25/07/2023		SURVEY FILE No.	431132-28-ASW A	DRAWN	PL
B	Add G1/19, Chg Pipe Mat	20/09/2023		FIELD BOOK		DATE	25/07/2023
				LOG BOOK		CHECKED	MJT
				LEVEL DATUM	AHD	DATE	20/09/2023
				DATUM	PM 108673	RL	17.338


BRISBANE (07) 3066 4700
MACKAY (07) 4957 3700
WHITSUNDAYS (07) 4945 6000
CAIRNS (07) 4252 9400
 veris.com.au
 ACN 615 735 727
 Veris Australia Pty Ltd

SCALE 1:250 ORIGINAL SIZE A1


MORETON BAY REGIONAL COUNCIL
 CABOOLTURE DISTRICT OFFICE
 2 HASKING STREET CABOOLTURE QLD 4510
 PO BOX 159 CABOOLTURE QLD 4510
 Telephone: (07) 5433 0100
 Fax: (07) 5433 4000

STAGES 28
RIVERPARKS ESTATE
AS CONSTRUCTED
STORMWATER DRAINAGE

MBRC SUBDIVISION REFERENCE	
DA/28428/2013/VCHC/1	
No. 3 OF 3 PLANS	
DRAWING NUMBER	REV.
431132-28-ASW	B