



LEGEND

- PVC-U 500 Ø750
Grade 10/11 SEWER MAIN
- Sewer House Connection
- Sewer Maintenance Hole (INSITU)
- Sewer Line Bend
- Existing Sewer Maintenance Shaft

ENGINEER'S CERTIFICATION

I, _____, hereby certify that:

- The information contained in this drawing / document is in compliance with approved drawings and design.
- The new water and sewerage works defined by this drawing have been designed and constructed in accordance with the SEQ Code.
- This represents an accurate record of as-constructed works.
- I accept responsibility for the information contained in this drawing / document.


RPED (signature) RPED No. _____ Date _____

REGISTERED SURVEYOR'S CERTIFICATION

I, **Veris Australia Pty Ltd**, hereby certify that the vertical and horizontal locations and dimensions shown on this plan are a true and correct record and were located by survey.

6448 **18/11/2024**
 Old Registered Surveyor (sig) Old Reg. Surveyor No. Date

COORDINATE DATUM NOTE:
 HORIZONTAL COORDINATES (E, N) SUPPLIED ARE MAPPING GRID OF AUSTRALIA (MGA), ZONE 56 BASED ON THE UNIVERSAL TRANSVERSE MERCATOR PROJECTION AND THE GEOCENTRIC DATUM OF AUSTRALIA 1994.
 HORIZONTAL DATUM DERIVED FROM PM33280, E 492232.092, N 7002357.242.
 LEVELS SUPPLIED ARE ON THE AUSTRALIAN HEIGHT DATUM (AHD).
 LEVEL DATUM DERIVED FROM PSM108673 RL 17.338 (AHD).

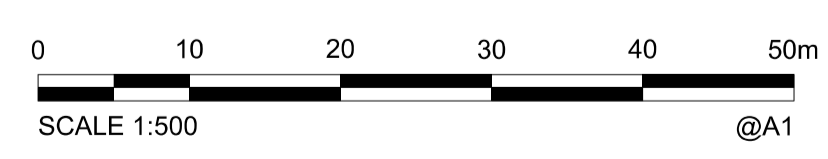

AS CONSTRUCTED

A1	B	24/09/2024	ADD SURFACE LEVELS	JMc	DRAWN	JMc	19/09/2024
	A	19/09/2024	ORIGINAL	JMc	CHECKED	MJT	
	REVISIONS			DRAWN	CHECKED	PASSED	
	INDEX	DATE		DRAWN	CHECKED	PASSED	INITIALS DATE

BRISBANE WHITSUNDAYS
 (07) 3656 4700 (07) 4945 6600

MACKAY CAIRNS
 (07) 4901 9100 (07) 4232 9400


veris.com.au
 ACN 615 735 727
 Veris Australia Pty Ltd



Unitywater

OPW - TBC
 RIVERPARKS ESTATE
 PAULS ROAD UPPER CABOOLTURE
 STAGE 18 SEWER

SHEET 1 OF 2 SHEETS	SCALE 1:500
REVISION DATE 19/09/2024	REVISION B
DISCIPLINE CODE C	
DRAWING NO. U-2024-5396-SEW	

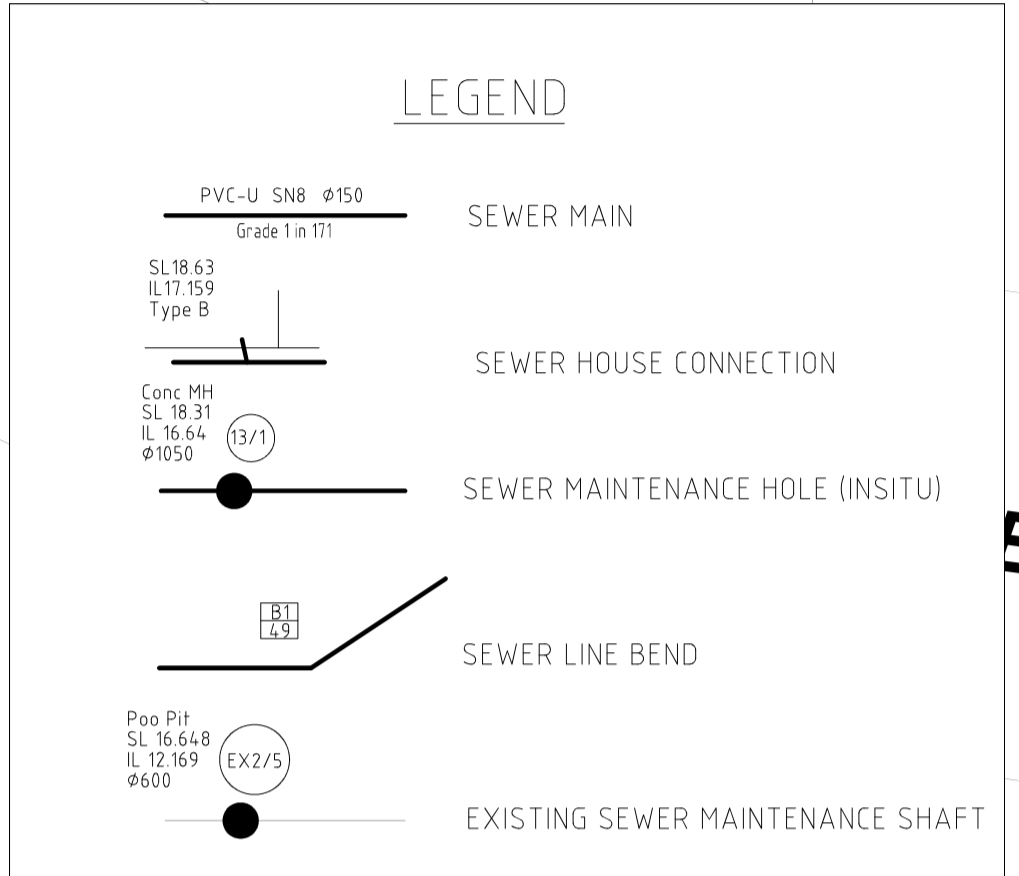

ENGINEER'S CERTIFICATION

I, _____ hereby certify that:

- The information contained in this drawing / document is in compliance with approved drawings and design.
- The new water and sewerage works defined by this drawing have been designed and constructed in accordance with the SEQ Code.
- This represents an accurate record of as-constructed works.
- I accept responsibility for the information contained in this drawing / document.

RPED (signature) RPED No. _____ Date: _____

REGISTERED SURVEYOR'S CERTIFICATION

I, **Veris Australia Pty Ltd**, hereby certify that the vertical and horizontal locations and dimensions shown on this plan are a true and correct record and were located by survey.

[Signature] 6448 18/11/2024
Old Registered Surveyor (sig) Old Reg. Surveyor No. Date

A1	B	24/09/2024	ADD SURFACE LEVELS	JMc			DRAWN	JMc	19/09/2024
	A	19/09/2024	ORIGINAL	JMc			CHECKED	GL	
	INDEX	DATE	REVISIONS	DRAWN	CHECKED	PASSED	INITIALS	DATE	


BRISBANE (07) 3664 4100
WHITSUNDAYS (07) 4644 9000
MACKAY (07) 4667 9700
CAIRNS (07) 4252 9400

veris.com.au
ACN 615 735 727
Veris Australia Pty Ltd



Unitywater
OPW - TBC
RIVERPARKS ESTATE
PUALS ROAD UPPER CABOODLURE
STAGE 18 SEWER

SHEET 2 OF 2 SHEETS	SCALE 1:250
REVISION DATE 19/09/2024	REVISION B
DISCIPLINE CODE C	
DRAWING NO. U-2024-5396-SEW	

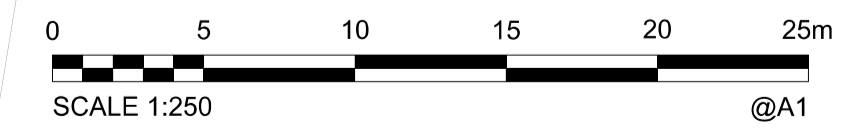

AS CONSTRUCTED

COORDINATE DATUM NOTE:
HORIZONTAL COORDINATES (E,N) SUPPLIED ARE MAPPING GRID OF AUSTRALIA (MGA), ZONE 56 BASED ON THE UNIVERSAL TRANSVERSE MERCATOR PROJECTION AND THE GEOCENTRIC DATUM OF AUSTRALIA 1994.
HORIZONTAL DATUM DERIVED FROM PM33280, E 492232.092, N 7002357.242.
LEVELS SUPPLIED ARE ON THE AUSTRALIAN HEIGHT DATUM (AHD).
LEVEL DATUM DERIVED FROM PSM108673 RL 17.338 (AHD).